
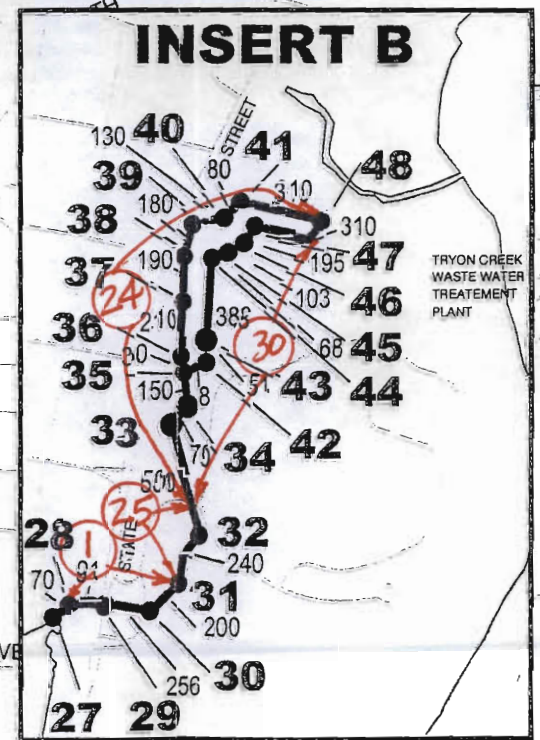
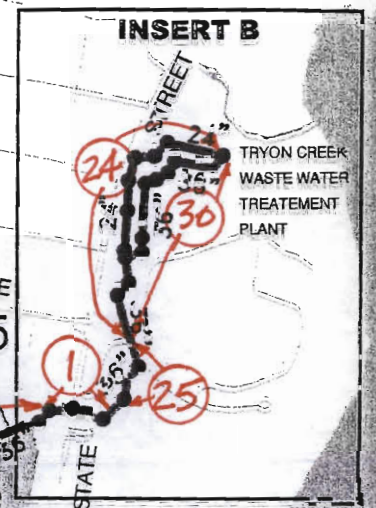


**KEY MAP FOR
RECORD DRAWINGS**

*CIRCLED NUMBERS CORRESPOND TO
NUMBERS ON UPPER RIGHT CORNER
OF RECORD DRAWINGS*

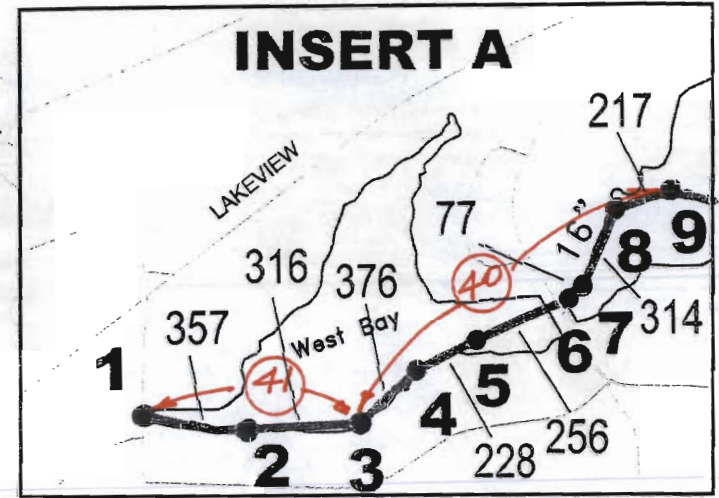

*SEE (31) FOR KEY
MAP FOR WEST BAY
MAIN CANAL, BLUE HERON BAY
AND SPRINGBROOK LID NOS. 68, 69, 70, 71*

FIGURE 1 City of Lake Oswego
Oswego Lake Interceptor and
Tributary Trunk Sewers
Scale: 1" = 1200' February 2002

